

City of San Jose - Building Division - Index Cover

Address 2415 S. King Rd.

PLAN CHECK NO. _____ PERMIT NO. 02041547

Prepared By _____ Date (Rev) 4-22-03

Category	Document Type	Sub Document Type
<input type="checkbox"/> MP Tracts	<input type="checkbox"/> TB Planning Permit	
	<input type="checkbox"/> PP Plot Plans	
	<input type="checkbox"/> TP Tract Plans	<input type="checkbox"/> PN Planning
		<input type="checkbox"/> BD Building
		<input type="checkbox"/> PB Plumbing
		<input type="checkbox"/> MM Mechanical
		<input type="checkbox"/> EE Electrical
	<input type="checkbox"/> TD Supporting Documents	
	<input type="checkbox"/> TC Structural Calculations	
	<input type="checkbox"/> TS Soils Report	
<input type="checkbox"/> TT Trusses/Shop Drawings		
<input type="checkbox"/> TM Tract Map	<input type="checkbox"/> AR Addressed	
<input checked="" type="checkbox"/> PL Plans BEMP	<input type="checkbox"/> PI Planing Permit	
	<input checked="" type="checkbox"/> EP Plans	<input type="checkbox"/> PA Planning
		<input checked="" type="checkbox"/> BL Building
		<input type="checkbox"/> BP Plumbing
		<input type="checkbox"/> BM Mechanical
		<input type="checkbox"/> BE Electrical
	<input type="checkbox"/> PM Parcel Map	
	<input type="checkbox"/> SC Structural Calculations	
	<input type="checkbox"/> SD Supporting Documents	
	<input type="checkbox"/> SR Soils Report	
<input type="checkbox"/> TR Trusses/Shop Drawing		
<input type="checkbox"/> CR Copy Request		
<input type="checkbox"/> PT Permits	<input type="checkbox"/> AD Addressing	
	<input type="checkbox"/> IN Inspection Notices	<input type="checkbox"/> EP Expired
	<input type="checkbox"/> PR Permits & Applications	<input type="checkbox"/> CC Cash Receipts / Refunds
		<input type="checkbox"/> CO C of O
		<input type="checkbox"/> CP Correspondence
		<input type="checkbox"/> EX Expired / Voided
		<input type="checkbox"/> FI Finals
		<input type="checkbox"/> IN Initial
		<input type="checkbox"/> IS Initial - Supporting Doc's
		<input type="checkbox"/> MR Meter Releases
		<input type="checkbox"/> SI Special Inspection Reports
	<input type="checkbox"/> CF Compliance Files	<input type="checkbox"/> CN Compliance Notices
		<input type="checkbox"/> RS Rescind
		<input type="checkbox"/> SW Stop Work Orders
	<input type="checkbox"/> DR Damage Reports	<input type="checkbox"/> ED Earthquake Damage
	<input type="checkbox"/> FD Flood Damage	
	<input type="checkbox"/> FA Fire/Auto Survey	

PROPER
Richard
1616 En
Campbell
APPLIC
Harmon
Contact
199 First
Los Altos
650-941
650-941

SYMBOLS


- SECTION NUMBER
- DRAWING NUMBER
- DETAIL NUMBER
- DRAWING NUMBER
- DOOR NUMBER
- WINDOW NUMBER
- EXTERNAL WALL FINISH NUMBER
- SHEAR WALL TYPE
- KEYNOTE

Bernp
02041547
2145
S. King
Pd

- CONTRACTOR SHALL PERSONALLY SUPERVISE AND DIRECT THE WORK OR SHALL KEEP A COMPETENT SUPERINTENDENT EMPLOYEE, AUTHORIZED TO RECEIVE INSTRUCTIONS AND ACT ON THE CONTRACTOR'S BEHALF, CONTINUOUSLY ON SITE DURING WORKING HOURS.
 - CONTRACTOR SHALL PROTECT CONSTRUCTION SITE, AND ALL MATERIALS AND FINISHES FROM DAMAGE WHICH MAY OCCUR FROM CONSTRUCTION, DEMOLITION, DUST, WATER, ETC., AND SHALL PROVIDE AND MAINTAIN TEMPORARY BARRICADES, CLOSURE WALLS, ETC., AS REQUIRED TO PROTECT THE PUBLIC AND OWNER DURING THE PERIOD OF CONSTRUCTION. DAMAGE TO NEW AND EXISTING MATERIALS, FINISHES, STRUCTURES, AND EQUIPMENT SHALL BE REPAIRED OR REPLACED. CONTRACTOR SHALL COORDINATE TEMPORARY BARRICADES WITH OWNER PRIOR TO COMMENCEMENT OF WORK AS NECESSARY.
 - CONTRACTOR SHALL BE RESPONSIBLE FOR CONSTRUCTION METHODS & MATERIALS AND CONSTRUCTION OF THE BUILDING IN ACCORDANCE WITH THE APPROVED PLANS AND PERMIT.
 - ALL SUBCONTRACTORS INCLUDING OWNER'S VENDORS ARE RESPONSIBLE FOR REMOVAL OF THEIR OWN DEBRIS AND WASTE MATERIALS IN THE FINISHED AREAS OR OUTSIDE THE JOBS.
- see sheet S-1 for required special inspection items.

APN: 670-020-042
(PARKING LOT)

CITY OF SAN JOSE BUILDING DIVISION
APPROVED PLAN SET
() OFFICE SET (X) FIELD SET
ADDRESS 2415 S. King Rd
PERMIT NO. 24151116
DATE 1/22/02
PC. No. 02-041547 DATE 4/22/02
CODE EDITIONS: (1) B.C. UNIFORM CODE 97 N.E.C. ENERGY DA
OCCUPANCY GROUP(S) A-3 TYPE OF CONSTRUCTION XV
PLANS APPROVED FOR: CHECKED BY APPROVED BY
(X) BUILDING NON STRUCT LP24 LP24/RE FORB REPAIRED LANE
(X) BUILDING STRUCT LP24 LP24/RE FORB
(X) ELECTRICAL
(X) PLUMBING
(X) MECHANICAL
(X) WIRE
(X) OTHER
(X) ZONING PLANNING PERMIT #

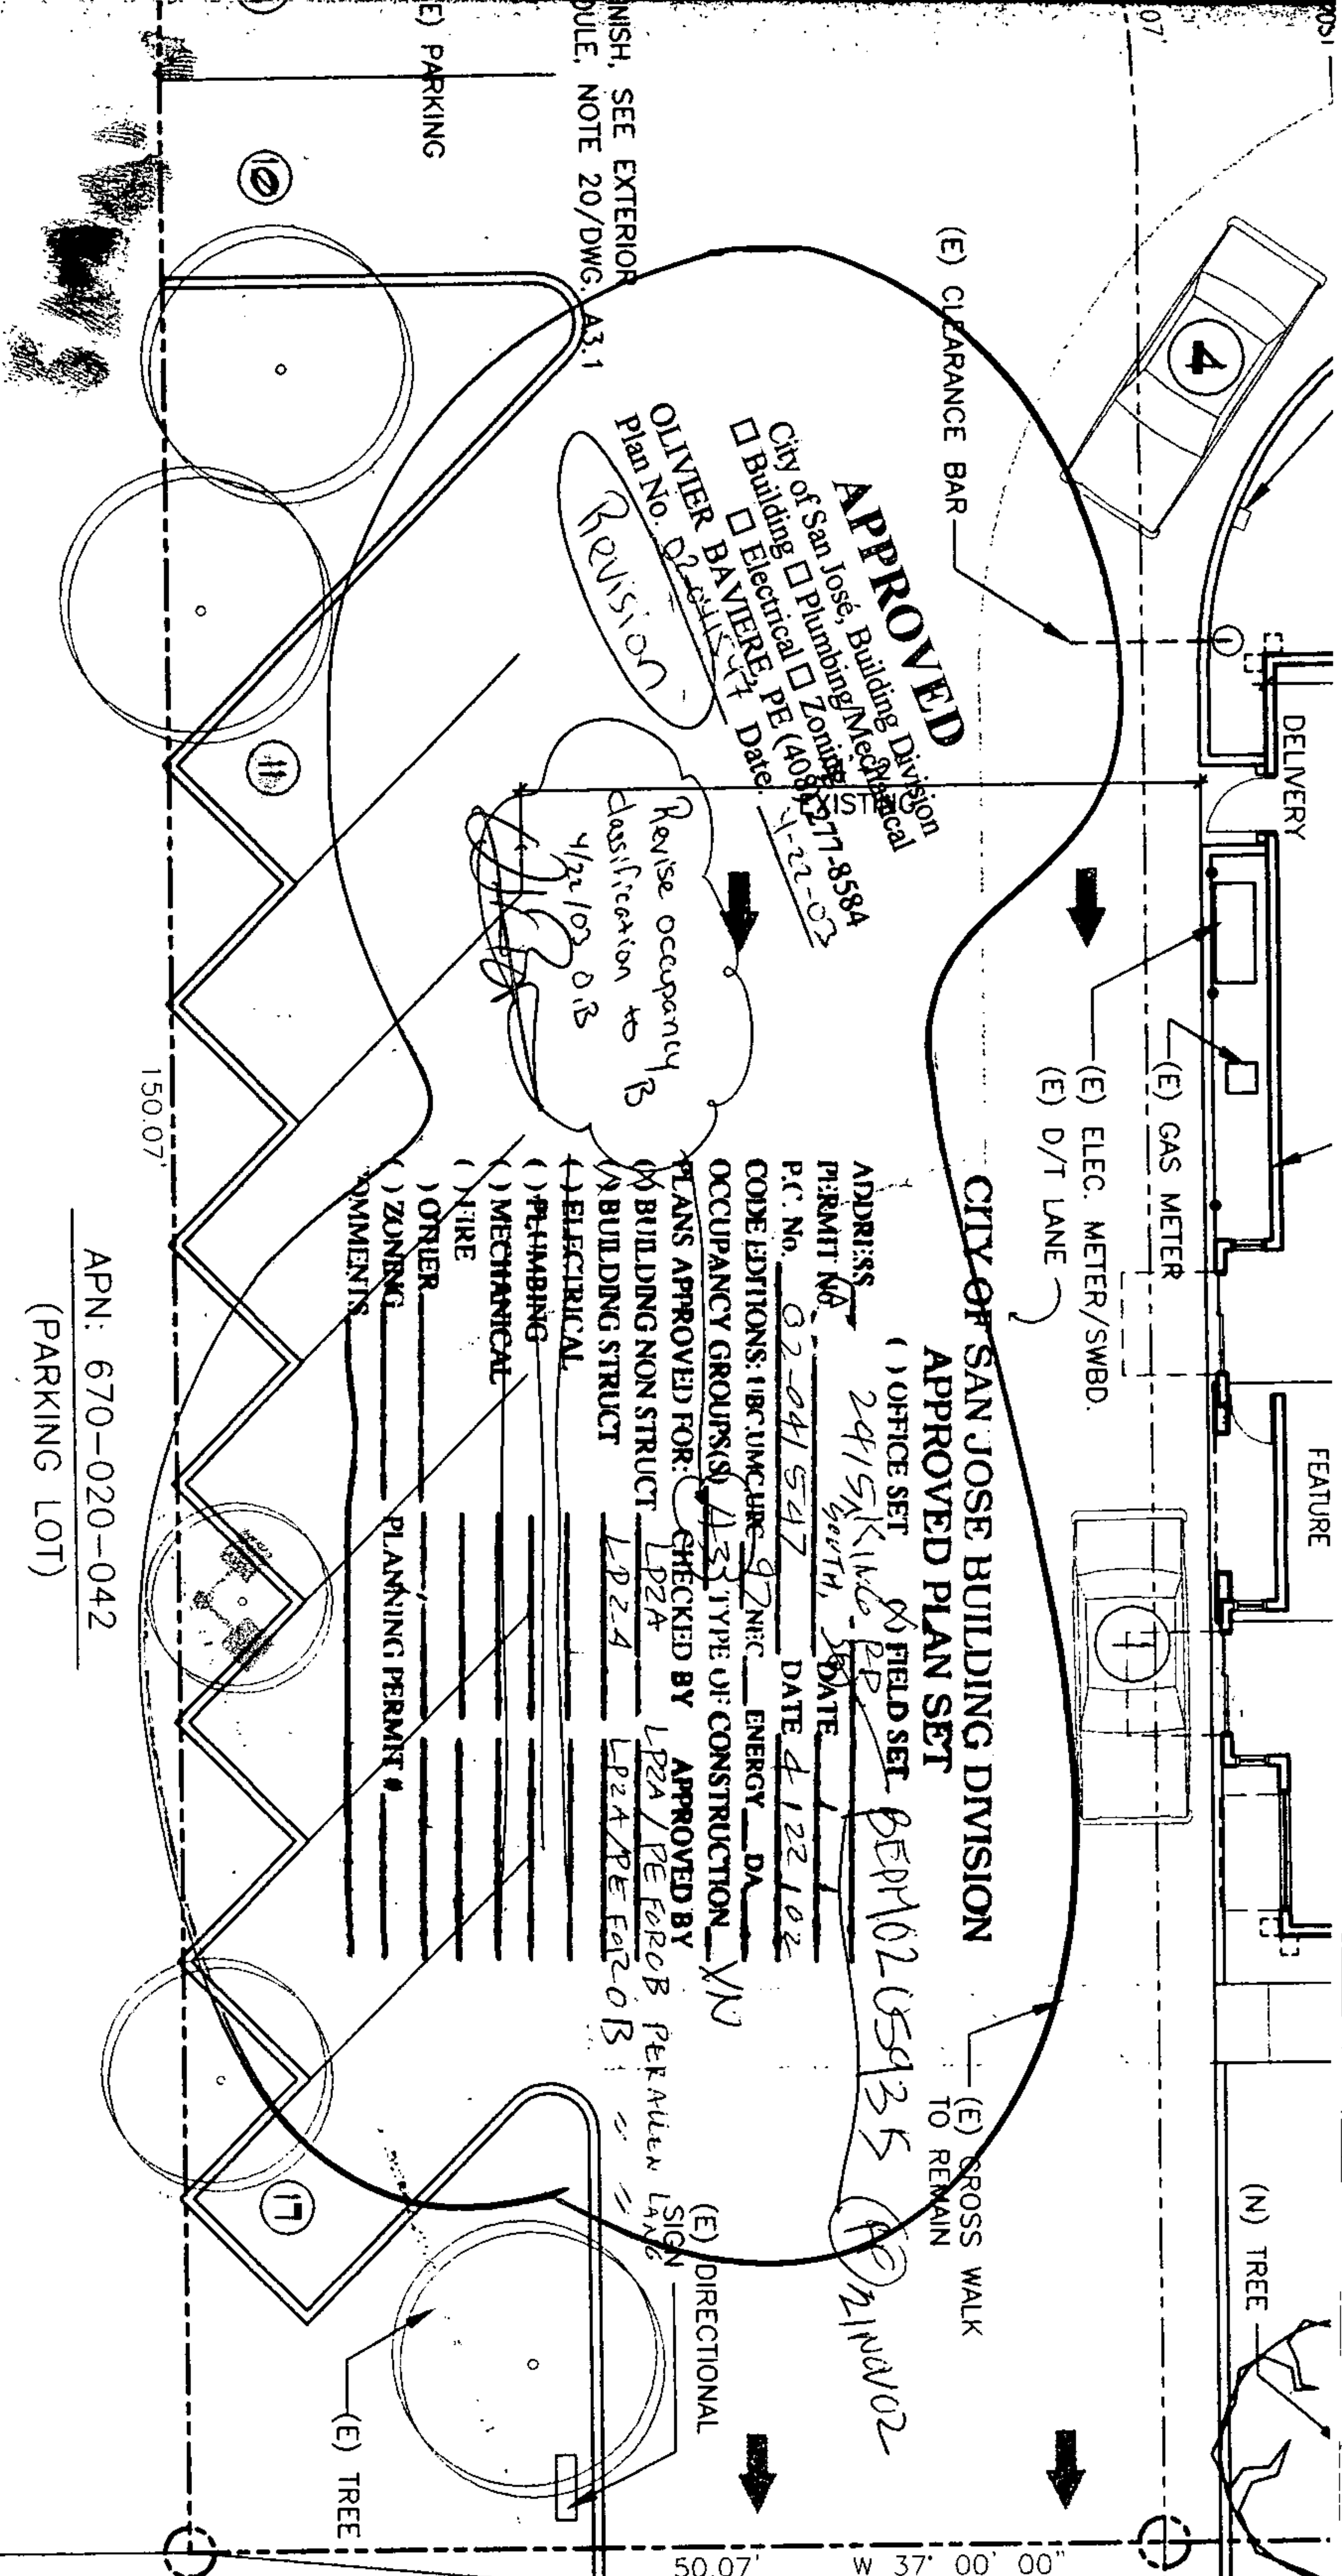

SCALE OFF THESE DRAWINGS, VERIFY ALL DIMENSIONS AND CONDITIONS IN THE FIELD. REPAIRS IN THESE DRAWINGS SHALL BE BROUGHT TO THE ATTENTION OF THE ARCHITECT STARTING WORK.

USED SUBSTITUTIONS SHALL BE APPROVED BY THE CONSTRUCTION MANAGER/OWNER, IN PRIOR TO BID SUBMITTAL AND INSTALLATION.

SUBMIT TRUSS SHOP DRAWINGS TO THE PROJECT ARCHITECT OR ENGINEER FOR REVIEW AND APPROVAL. REFER TO STRUCT. DRAWINGS FOR SPECIFIC TRUSS DESIGN AND SUBMITTAL REQUIREMENTS. FABRICATION SHALL NOT COMMENCE UNTIL SHOP DRAWINGS HAVE BEEN REVIEWED AND APPROVED BY THE CITY.

LISTED, SHOWN OR IMPLIED ON ANY CONSTRUCTION DOCUMENT SHALL BE SUPPLIED AND USED BY THE CONTRACTOR EXCEPT WHERE NOTED. THE CONTRACTOR SHALL CLOSELY COORDINATE HIS WORK WITH THAT OF THE OTHER CONTRACTORS OR VENDORS TO ASSURE THAT ALL WORK IS DONE IN CONFORMANCE WITH MANUFACTURER'S REQUIREMENTS. WORK REQUIRED UNDER THIS CONTRACT SHALL INCLUDE ALL LABOR, MATERIALS, ETC., NECESSARY TO COMPLETE THIS PROJECT. ALL MATERIALS SHALL BE NEW AND UNLESS SPECIFICALLY NOTED AND BE OF QUALITY ACCEPTABLE BY INDUSTRY STANDARDS.

ON OF THE SITE AND PORTIONS THEREOF WHICH WILL AFFECT THIS WORK SHALL BE MADE BY THE CONTRACTOR, WHO SHALL COMPARE IT WITH THE DRAWINGS AND SATISFY HIMSELF TO CONDITIONS UNDER WHICH WORK IS TO BE PERFORMED. CONTRACTOR SHALL TIME ASCERTAIN AND CHECK LOCATIONS OF THE EXISTING STRUCTURES AND EQUIPMENT